
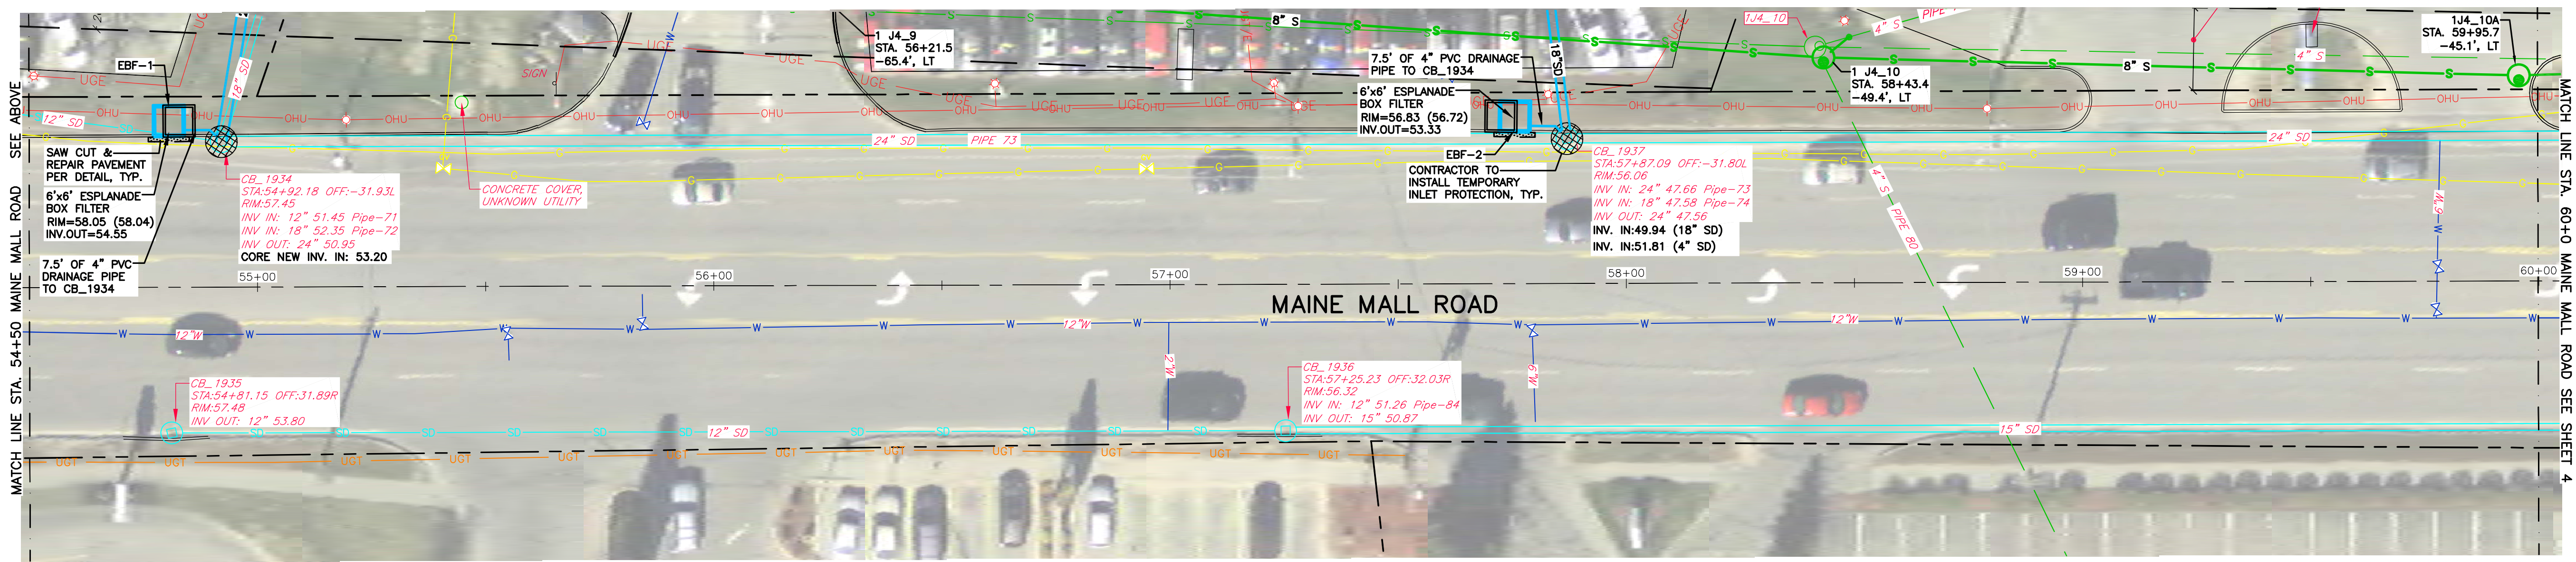


PLAN VIEW
1"=20'

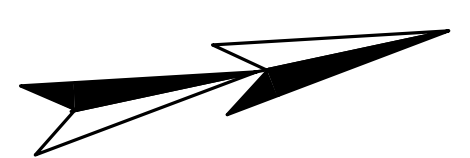


PLAN VIEW
1"=20'

REV'D	DATE	REVISIONS
1	05-18-14	RAM
2	05-20-15	RAM

DRAWN BY	BRE/JRH
APPROVED BY	
DATE	
CHECKED BY	RAM
DATE	
PROJECT NO.	13125
SCALE	AS NOTED

LONG CREEK WATERSHED
MANAGEMENT DISTRICT
35 MAIN STREET
SUITE 3
WINDHAM, MAINE 04062
207-892-4700


CITY OF SOUTH PORTLAND
MAINE MALL ROAD
DRAINAGE IMPROVEMENTS
STA. 49+50 TO STA. 60+00
LAYOUT PLAN

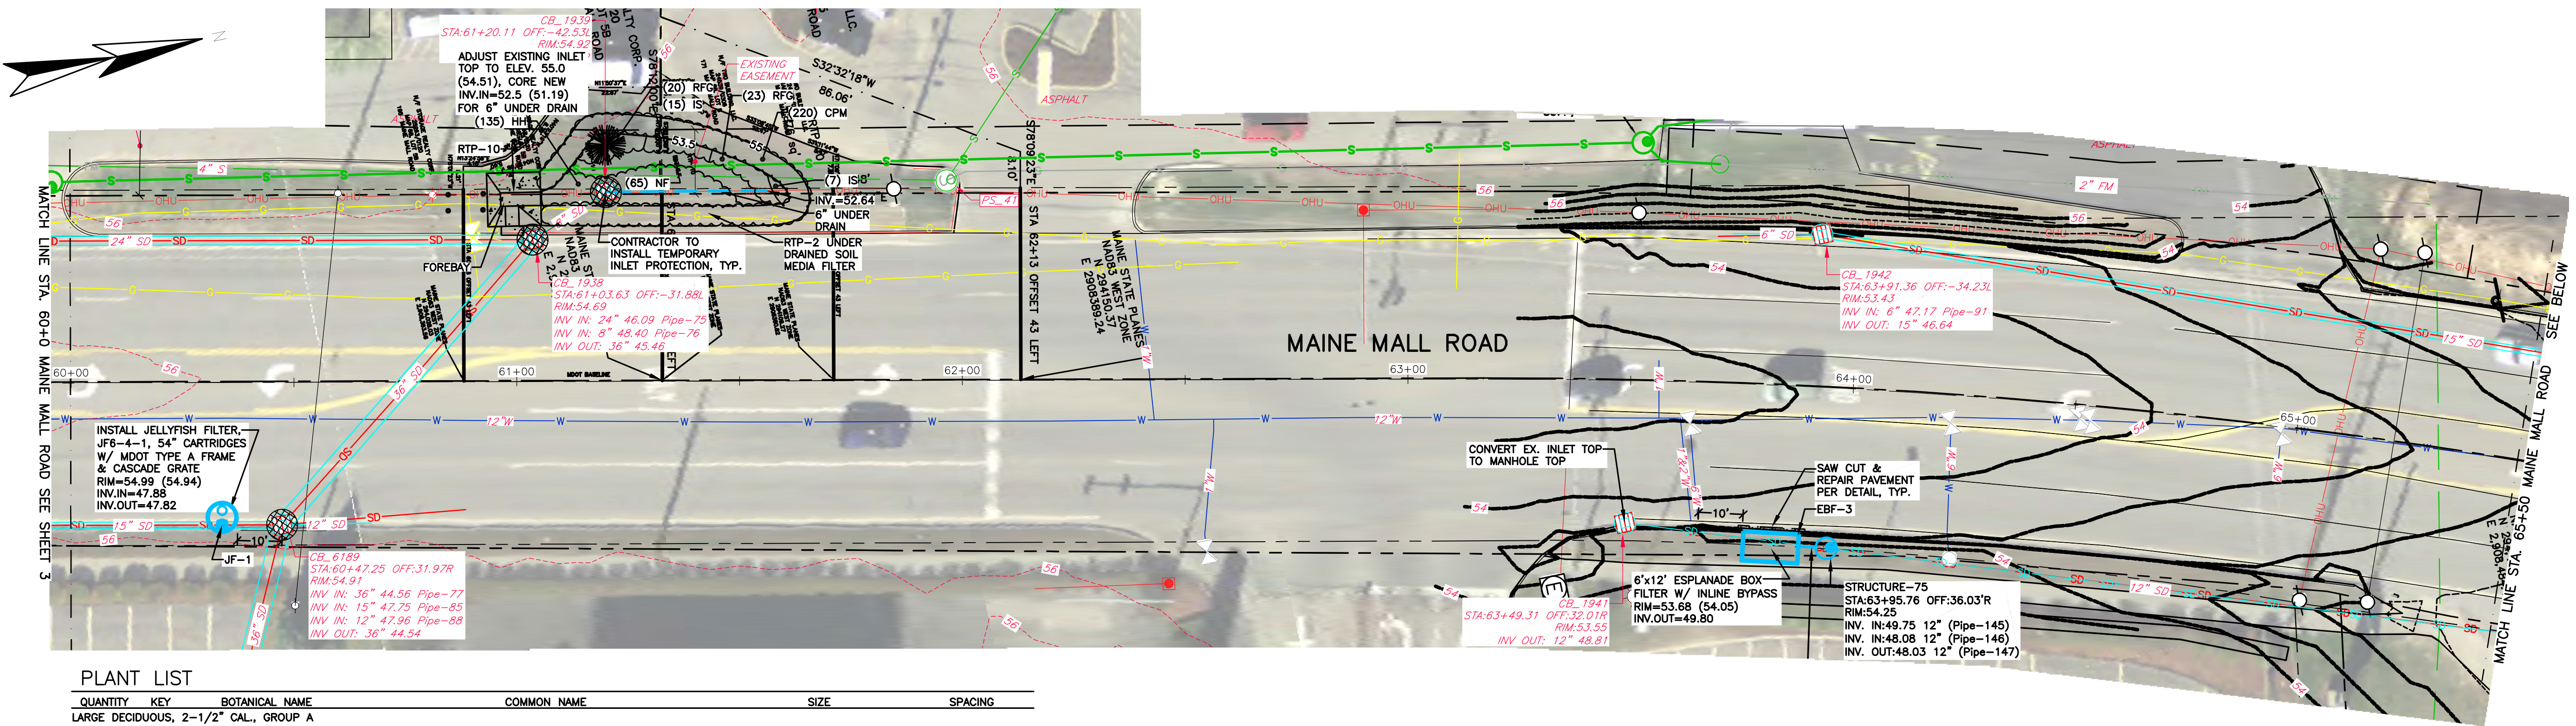

PLANT LIST

QUANTITY	KEY	BOTANICAL NAME	COMMON NAME	SIZE	SPACING
LARGE DECIDUOUS, 2-1/2" CAL., GROUP A	ZS	ZELKOVA SERRATA 'GREEN VASE'	GREEN VASE ZELKOVA		2-1/2" CAL.
HERBACEOUS PERENNIAL, NO. 1 CONT., GROUP A	HH	HEMEROCALLIS MIX	MIX VARIETIES DAYLILIES	NO. 1 CONT.	18" O.C.
	IS	IRIS SIBIRICA 'CAESARS BROTHER'	CAESAR'S BROTHER IRIS	NO. 1 CONT.	18" O.C.
	MSG	MISCANTHUS SINENSIS 'GRACILLIMUS'	MAIDEN GRASS	NO. 1 CONT.	18" O.C.
	NF	NEPETA FAASSENII 'WALKER'S LOW'	WALKER'S LOW CATMINT	NO. 1 CONT.	18" O.C.
	RFG	RUDBECKIA FULGIDA 'GOLDSTURM'	GOLDSTURM BLACK-EYED SUSAN	NO. 1 CONT.	18" O.C.
HERBACEOUS PERENNIAL, 4" CELL, GROUP B	CPM	CALLIRHOE INVOLUCRATA	POPPY MALLOW	4" CELL	18" O.C.

PLAN VIEW
1"=20'

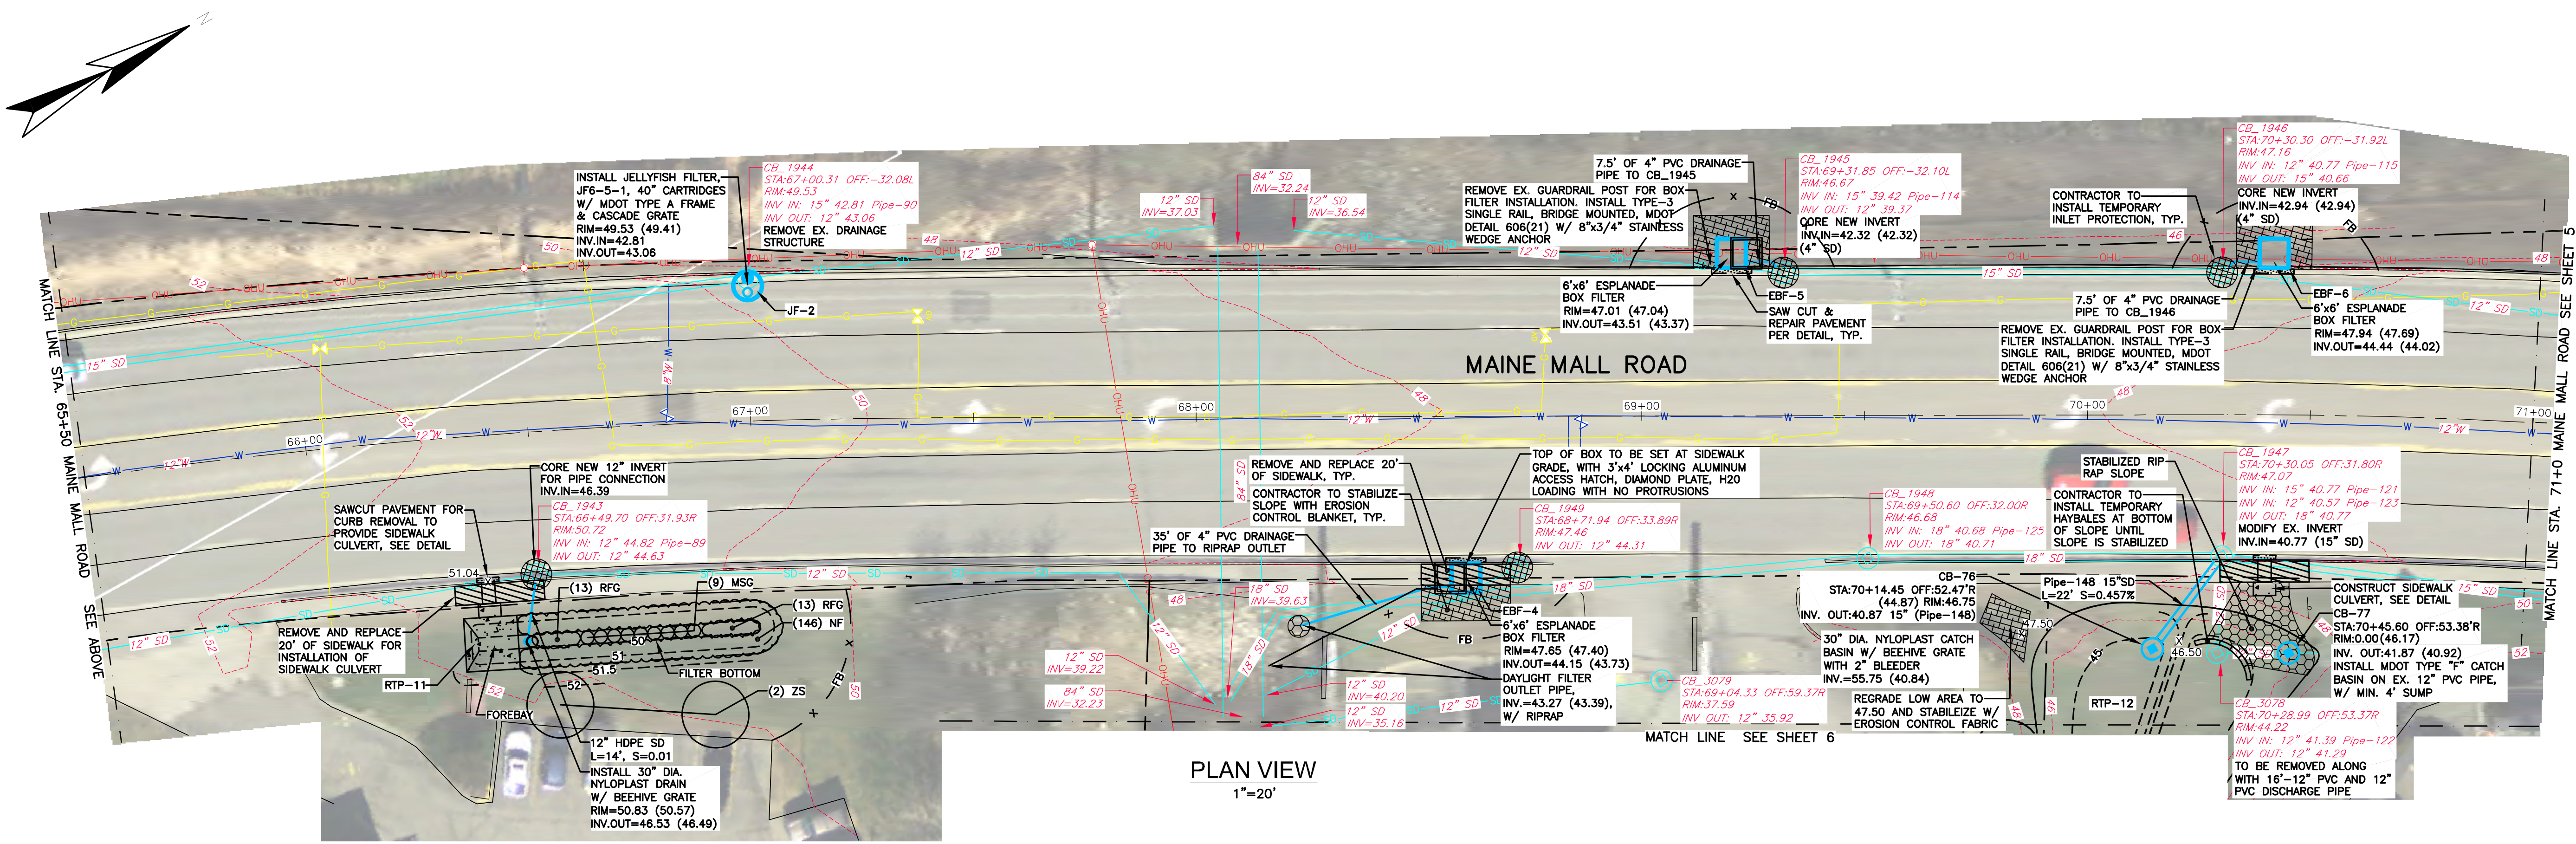

PLAN VIEW
1"=20'



DATE	5/23/2016
BY	HILZORRANTS
CHECKED BY	RAM
DATE	5/23/2016
PROJECT NO.	13125
SCALE	AS NOTED

REVISIONS		
NO.	DATE	DESCRIPTION



LONG CREEK WATERSHED MANAGEMENT DISTRICT
35 MAIN STREET
SUITE 3
WINDHAM, MAINE 04062
207-892-4700
LONG CREEK Watershed Management District

CITY OF SOUTH PORTLAND
MAINE MALL ROAD
DRAINAGE IMPROVEMENTS
STA. 60+0 TO STA. 71+0
LAYOUT PLAN

DWG 4

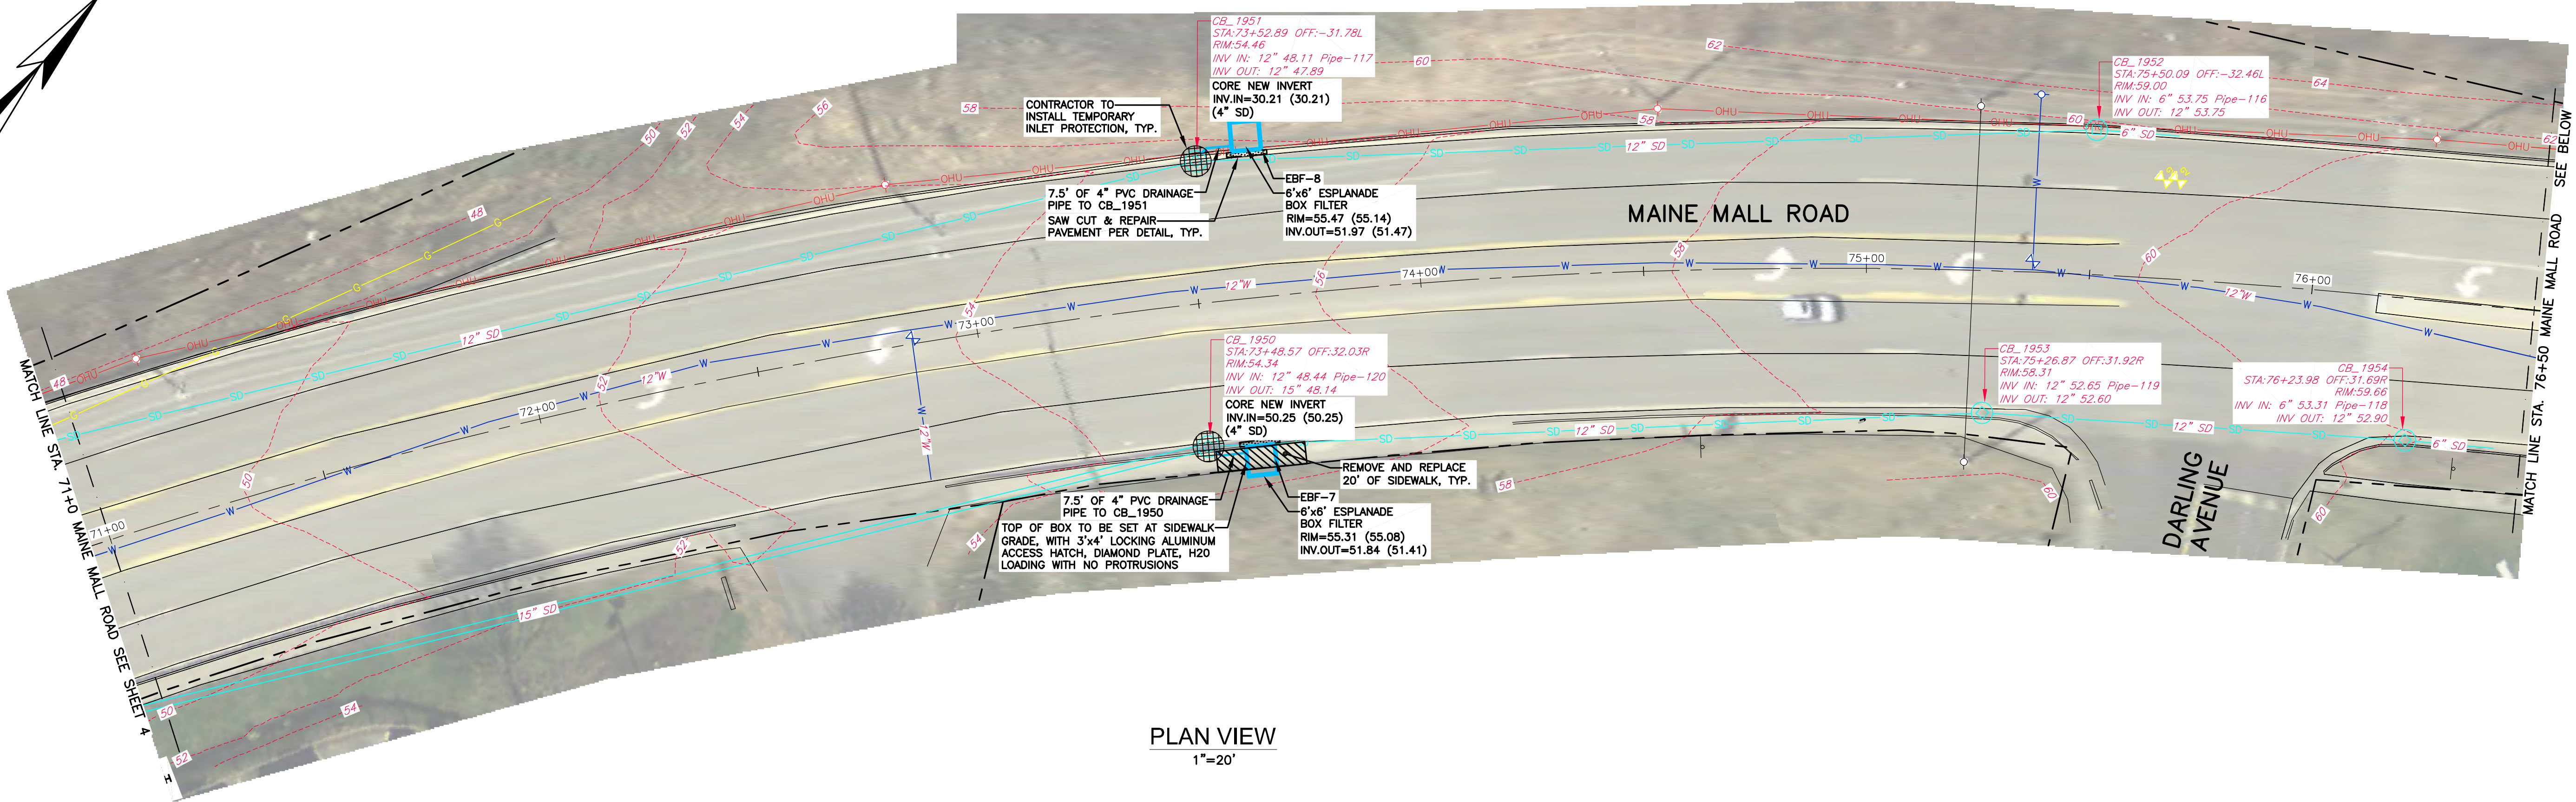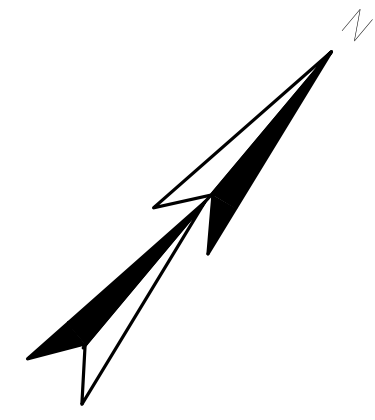

PLAN VIEW
1"=20'

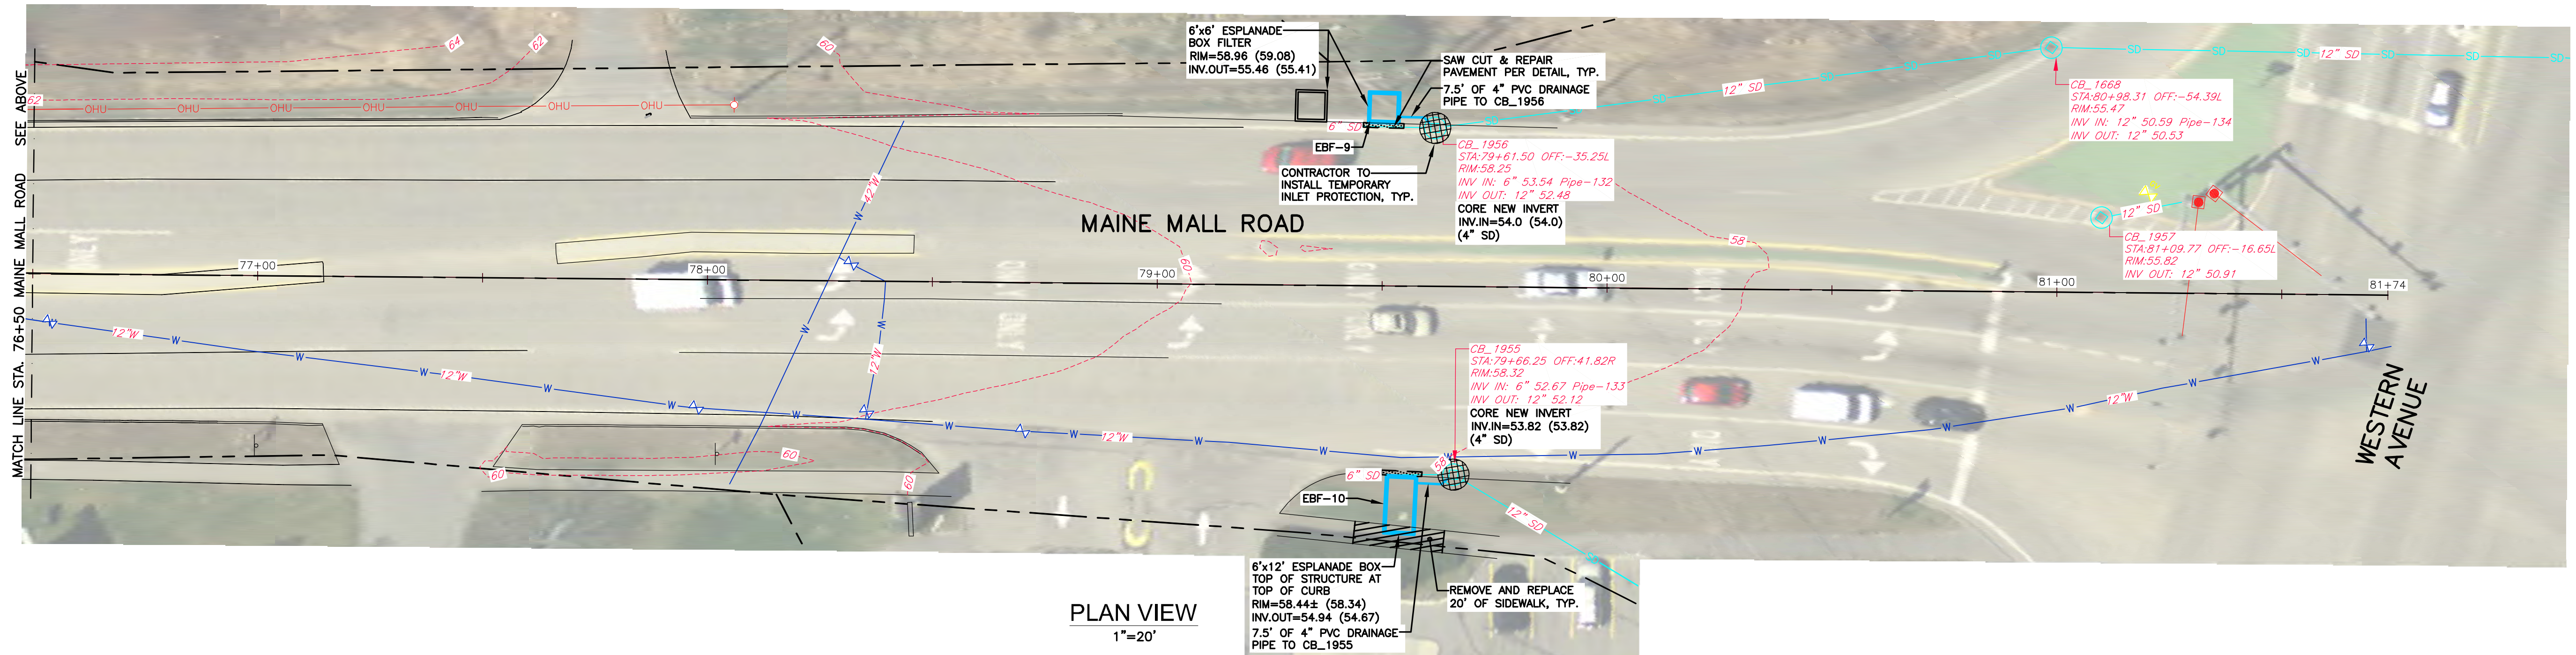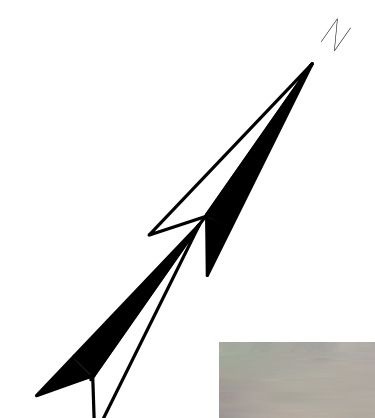

PLAN VIEW
1"=20'



DATE	REVISIONS
05-18-14	RAM
05-20-15	RAM

DATE	APPROVED BY	DATE	CHECKED BY

DATE	PROJECT NO.	SCALE
	13125	AS NOTED



CITY OF SOUTH PORTLAND
MAINE MALL ROAD
DRAINAGE IMPROVEMENTS
STA. 71+0 TO STA. 81+74

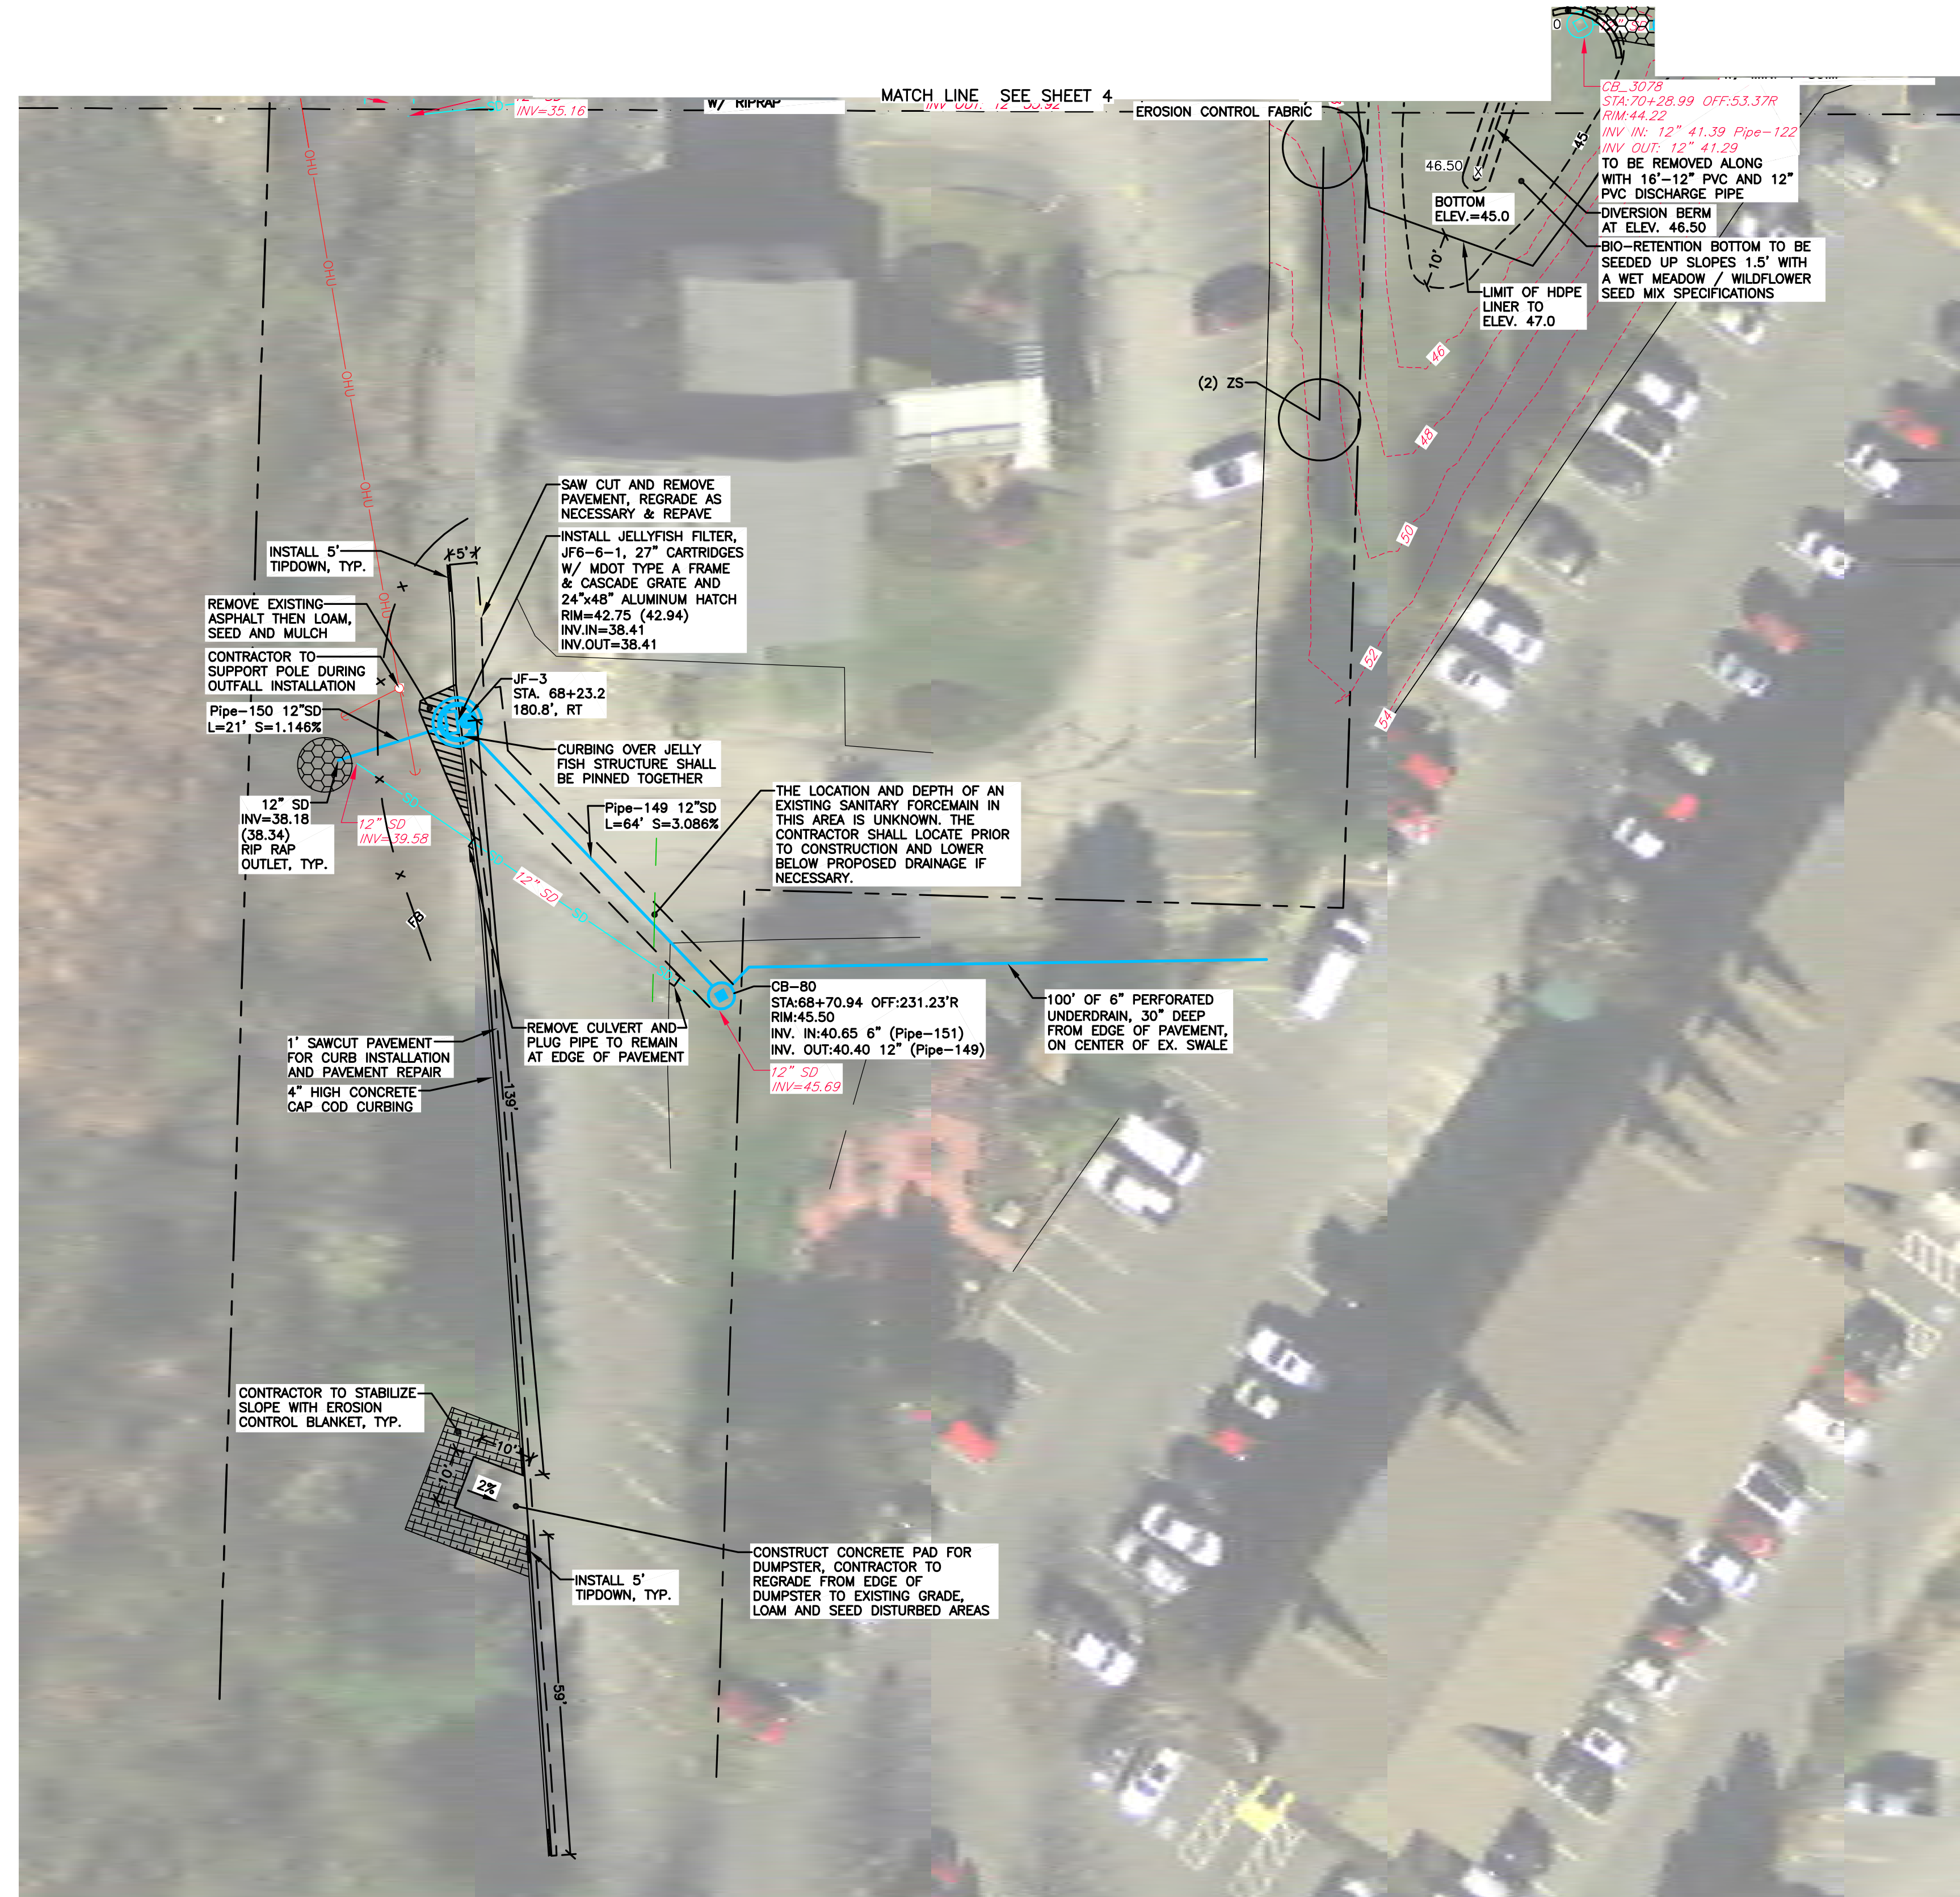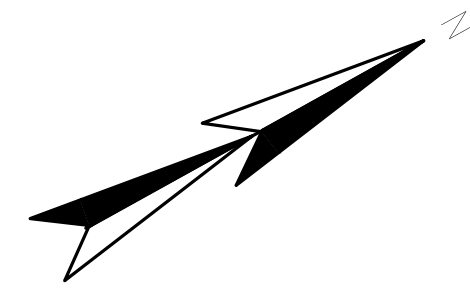

PLAN VIEW
1"=20'

DATE	REVISIONS
03-18-14	RAM
03-20-15	RAM

DATE	APPROVED BY	DATE	CHECKED BY	DATE	PROJECT NO.	SCALE
					13125	AS NOTED

DRAWN BY: BRF/JRH APPROVED BY: _____ DATE: _____ CHECKED BY: RAM DATE: _____ PROJECT NO.: 13125 SCALE: AS NOTED

LONG CREEK WATERSHED
MANAGEMENT DISTRICT
35 MAIN STREET
SUITE 3
WINDHAM, MAINE 04602
207-892-4700

CITY OF SOUTH PORTLAND
MAINE MALL ROAD
DRAINAGE IMPROVEMENTS
OUT OF RIGHT OF WAY AREA
LAYOUT PLAN